

SOLAR THERMAL SYSTEM DESCRIPTION

DESERT ROSE HOUSE WILL UTILISE A THERMAL STORAGE HEAT EXCHANGE TANK IN CONJUNCTION WITH TRACTILE BIPV-T SOLAR TILES. THE SYSTEM SERVES TWO PURPOSES:

1. PRODUCING DOMESTIC HOT WATER BY PUMPING WATER THROUGH THE TRACTILE SOLAR TILES
2. COOLING DOWN THE SOLAR PANELS TO AT OR BELOW THE NOMINAL OPERATING CELL TEMPERATURE TO ENSURE MAXIMUM EFFICIENCY.


THE TANK WILL UTILISE A WATER LOOP TO THE TRACTILE SOLAR TILES. WHEN THE WATER IN THE TILES INCREASES ABOVE 45°C, THE PUMP WILL START UP, CAUSING COOL WATER TO FLOW FROM THE TANK THROUGH THE TRACTILE PANELS. THIS WATER THEN RE-ENTERS THE HEAT EXCHANGE TANK AT 45-50°C HEATING THE SURROUNDING POTABLE WATER IN THE TANK. THIS WATER IS THEN ELECTRICALLY BOOSTED BY A 2 KW HEATING ELEMENT TO 60°C WHICH IS THE SUPPLIED TO THE FIXTURES WITHIN THE HOUSE.

REFER TO SW-002 FOR SOLAR HOT WATER DRAWING.


ROTEX SANICUBE HEAT EXCHANGE TANK



TRACTILE SOLAR PANELS WITH IN-BUILT WATER PIPES

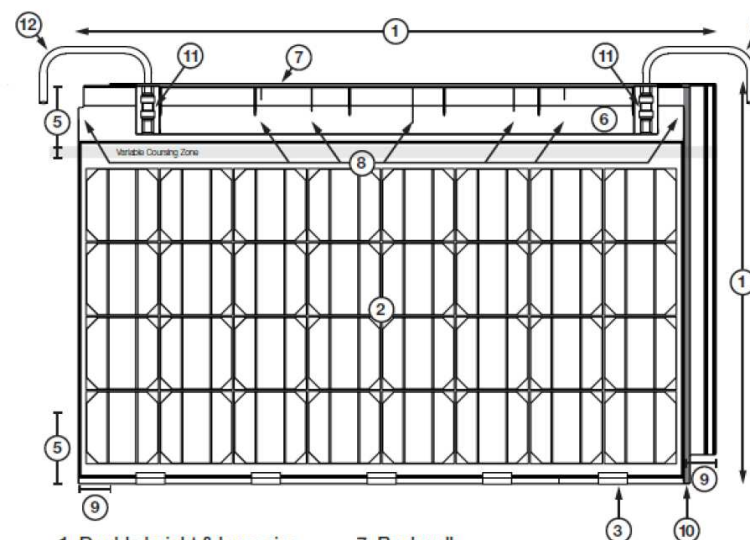

- 1. Double height & large size
- 2. Photovoltaic module
- 3. Low profile tile edge
- 4. Hook and batten fixing system
- 5. Head and tail lap zones
- 6. Ramp
- 7. Backwall
- 8. Offset markers & baffles
- 9. Side lapping
- 10. Silicone bead channel
- 11. SharkBite® push-fit connector
- 12. Tractable 'U' copper pipe

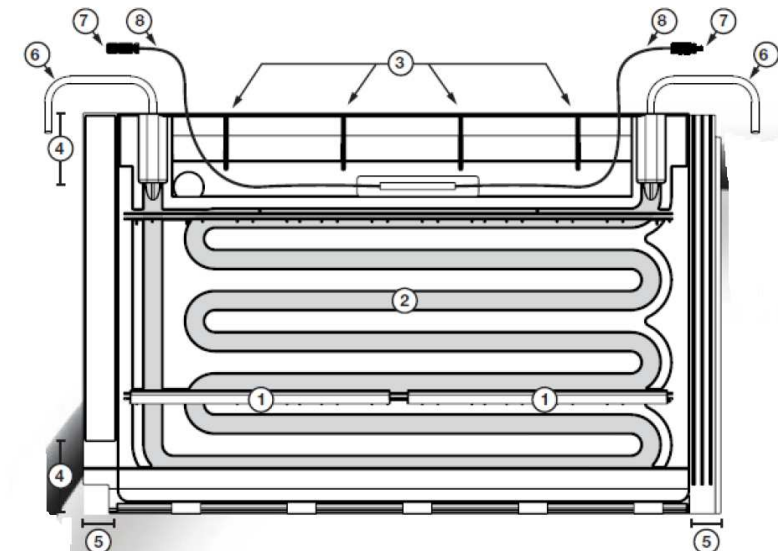

- 1. Lower hooks
- 2. Pipe channel
- 3. Support fins
- 4. Head and tail lap zones
- 5. Side lapping
- 6. Tractable 'U' copper pipe
- 7. MC4 connector
- 8. Cable 600mm

1 Solar Thermal Information



Team: TEAM UOW
Address: UNIVERSITY OF WOLLONGONG
 WOLLONGONG
 NSW, AUSTRALIA 2522
Contact: sd-2018@uow.edu.au
 www.desertrosehouse.com.au

Client: Dubai Electricity and Water Authority
SOLAR DECATHLON
 MIDDLE EAST
 DUBAI, UAE - 2018


AMENDMENTS					
REV.	DESCRIPTION	DATE	DRAWN	CHECK	
	Updated to As-Built	14/09/18	VP	JR	

COPYRIGHT	
None; Project is Public	
LOT	# M
DRAWER	B.BANFIELD
CHECKED	V.PHAM
DATE	09 May, 2018
SCALE	N.T.S. @ A3

SOLAR THERMAL INFO AND DETAILS

SHEET: 01 OF 01

SW-001

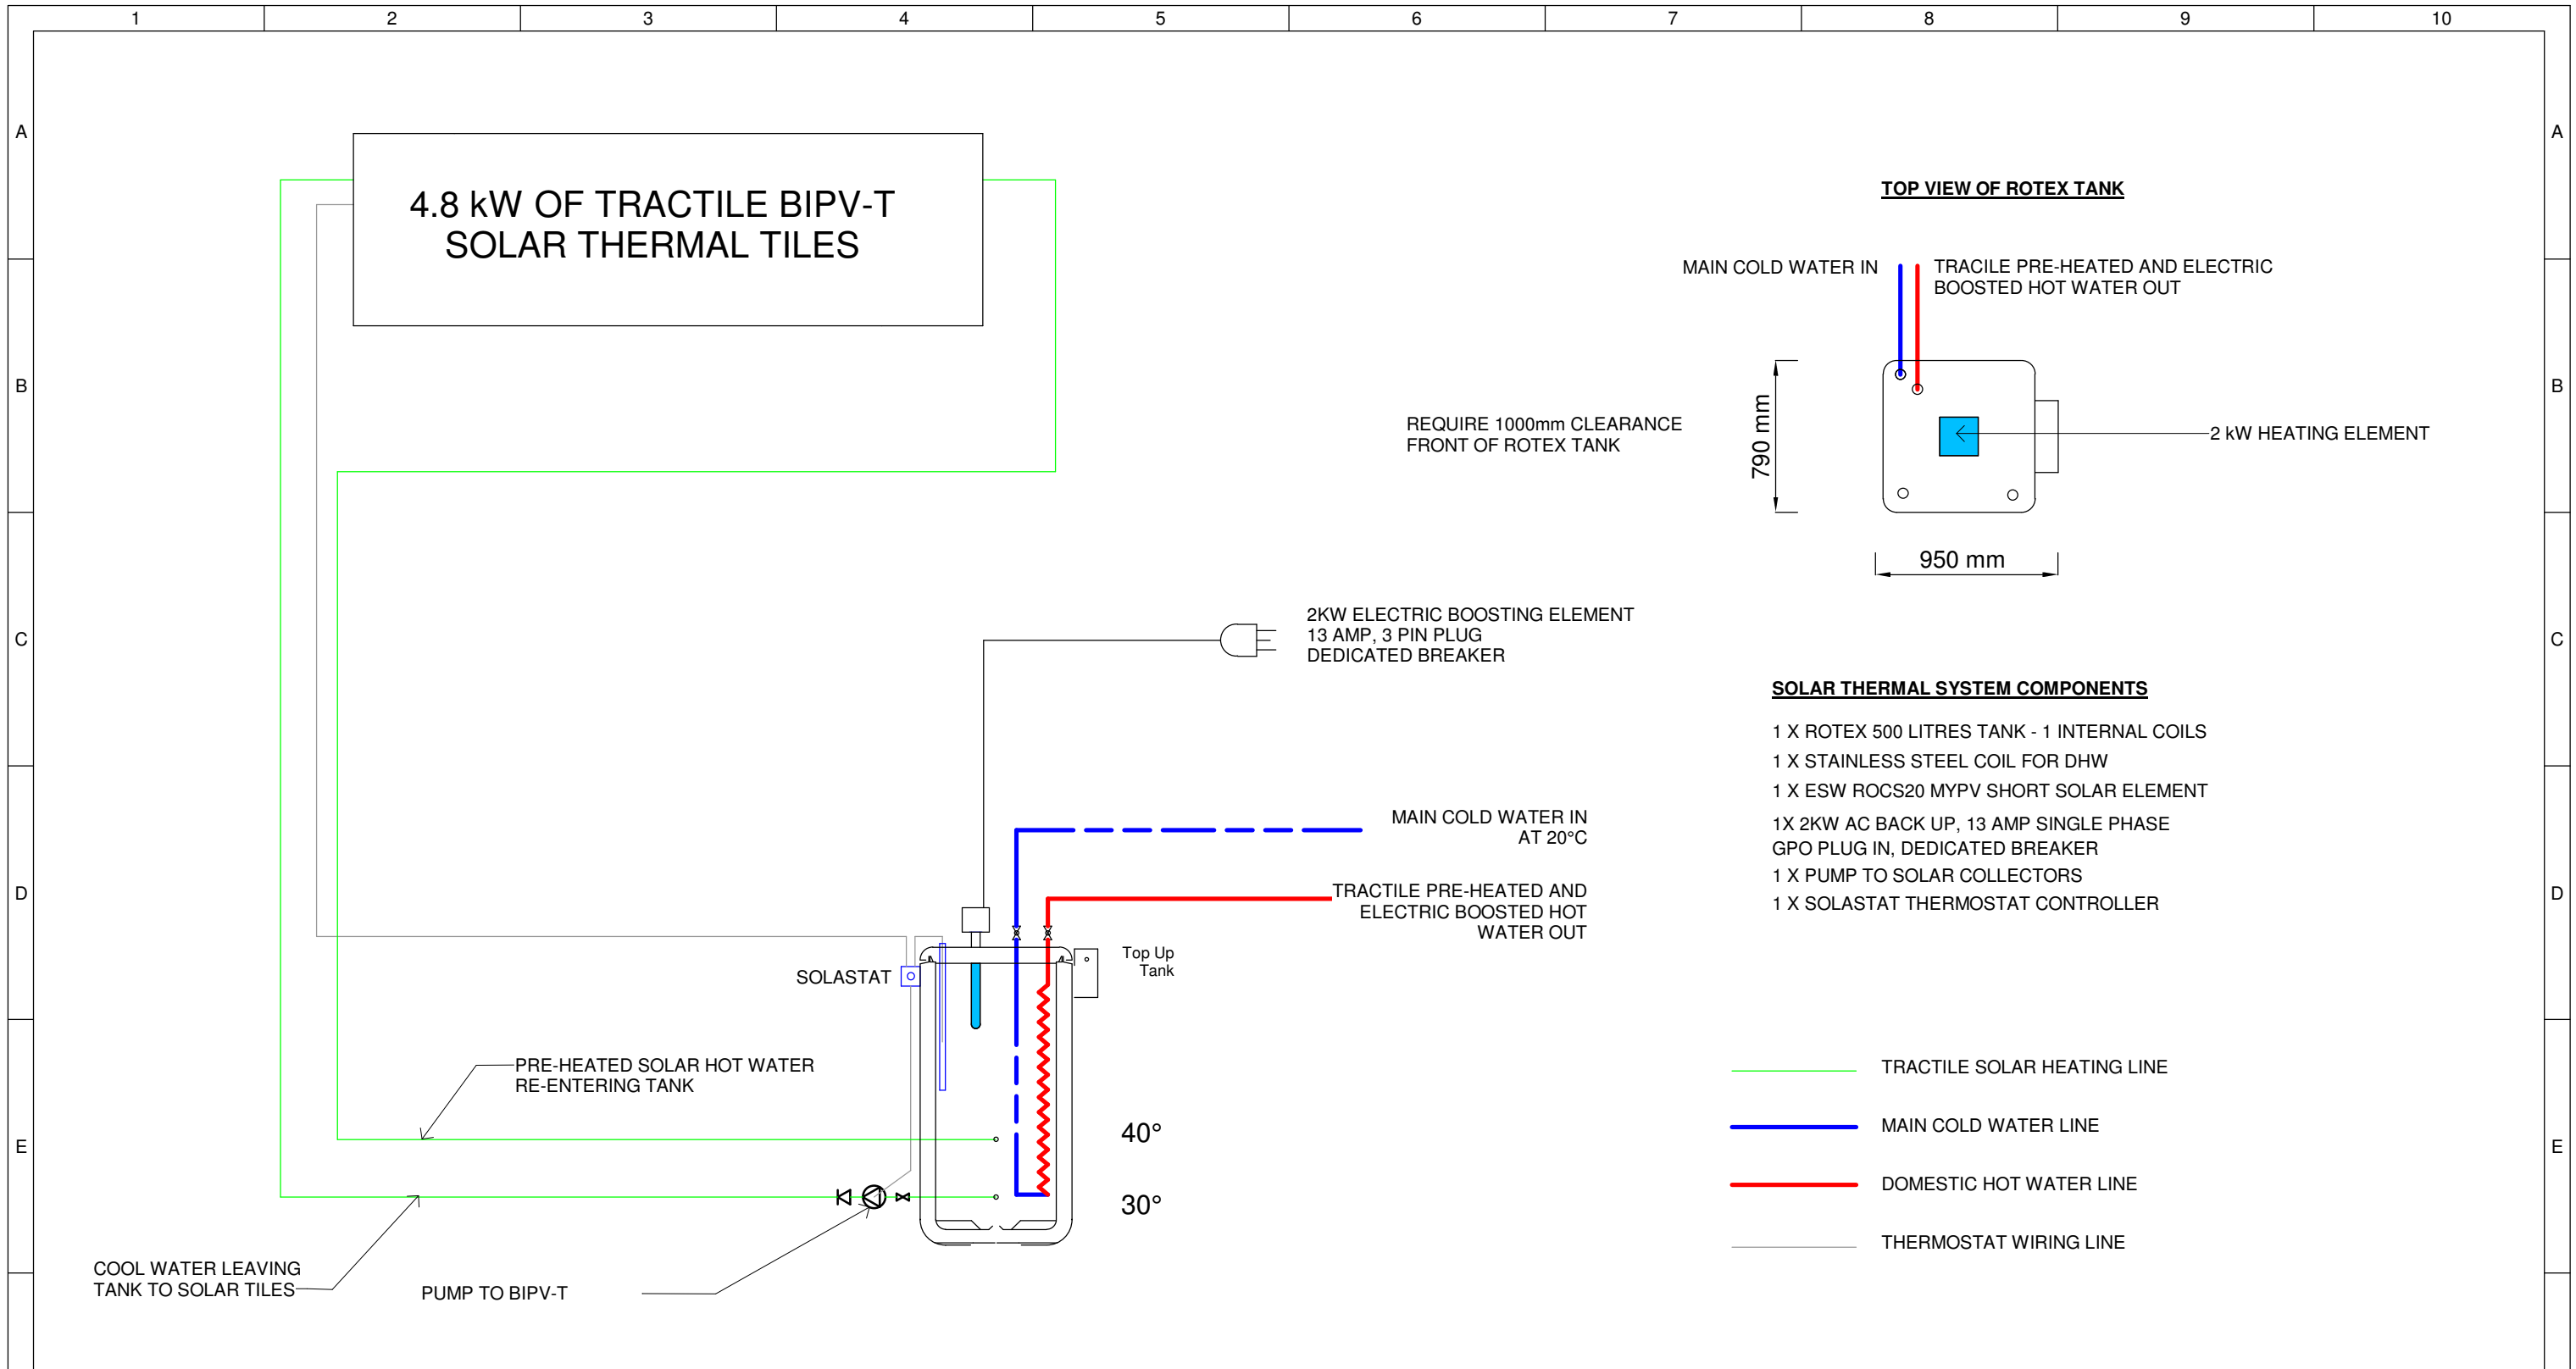

1 Solar Thermal System Schematic

	Team: TEAM UOW Address: UNIVERSITY OF WOLLONGONG WOLLONGONG NSW, AUSTRALIA 2522 Contact: sd-2018@uow.edu.au www.desertrosehouse.com.au	Client: Dubai Electricity and Water Authority 	AMENDMENTS <table border="1"> <thead> <tr> <th>REV.</th> <th>DESCRIPTION</th> <th>DATE</th> <th>DRAWN</th> <th>CHECK</th> </tr> </thead> <tbody> <tr> <td></td> <td>Updated to As-Built</td> <td>14/09/18</td> <td>VP</td> <td>JR</td> </tr> </tbody> </table>	REV.	DESCRIPTION	DATE	DRAWN	CHECK		Updated to As-Built	14/09/18	VP	JR	COPYRIGHT None; Project is Public LOT # M DRAWER B.BANFIELD CHECKED C.MCDOWELL DATE 09 May, 2018 SCALE N.T.S. @ A3	SOLAR THERMAL SYSTEM SCHEMATIC SHEET: 01 OF 01 SW-002
	REV.	DESCRIPTION	DATE	DRAWN	CHECK										
	Updated to As-Built	14/09/18	VP	JR											
1	2	3	4	5	6	7	8	9	10						